Date User: Monday, 2/25/2008 7:33:38 A

Kim Johnston

**Process Sheet** 

Customer Job Number : CU-DAR001 Dart Helicopters Services

37530

Estimate Number : 13161

P.O. Number

This Issue - - "

: 2/25/2008

S.O. No. :

: NC

Prsht Rev. : // First Issue

: 37491 Previous Run

Written By

Comment

Checked & Approved By

08-01-30

: SMALL /MED FAB

Project Number **Drawing Revision** 

**Drawing Name** 

Part Number

**Drawing Number** 

Material

Due Date

Description:

: 2/25/2008

: D37291

: N/A

: U/R

106747x2

106187 xZ

8-5-92

D3729 U/R

: STEP BRACKET

Qty:

Each 4 Um:

Bach

**Additional Product** 

Job Number:

Seq.#: noith Sic. no

ostic.

Sec. 37.

., ., ., 2.0

Machine Or Operation:

M6061T6B0500X05000

4.0249 f(s)

new issue DD verifyed by:EC

6061-T6 Bar .50" x 5.0"

Cityaner The bosines on

WATER JET

Comment: Qty.: 1.0062 f(s)/Unit Total: 6061T6 aluminium bar 5.00" X .50" thick

(M6061T6B0500X05000) Batch:

FLOW WATER JET

Comment: FLOW WATER JET

1-Cut as per Dwg D3729 Dwg Rev: UR

Prog Rev: UR

B 8-3-35

2- Deburr if necessary + 1-8

QC2

8-9-72

SECOND CHECK

Comment: INSPECT PARTS AS THEY COME OFF MACHINE

4.0

3.0

F) 10.3(#2-15

QC8

Comment: SECOND CHECK

5.0

SMALL FAB 1

ŠMALL & MEDIUM FAB RESOURCE 1

INSPECT PARTS AS THEY COME OFF MACHINE



Comment: SMALL & MEDIUM FAB RESOURCE 1

1- Deburr if necessary

2- grind water jet markes all around bracket 5mockh

\* \* \* do not grind inside where step extrusion goes \*\*\*

## **Dart Aerospace Ltd**

<b>W</b> /O:		WORK ORDER CHANGES						
DATE	STEP	PROCEDURE CHANGE	Ву	Date	Qty	Approval Chief Eng / Prod Mgr	Approvai QC Inspector	
u.								
بب		;						

Part No	•	PAR #:	Fault Ca	tegory:N	CR: Yes N	DQA:	Date: _	08/03/,7
				<b>.</b> .	QA: N/C	Closed:	_ Date: _	
NCR:		V	ORK OR	DER NON-CONFORMANC	E (NCR)			
		Description of NC	Corrective Action Section B	ve Action Section B Verification Approval			Approval	
DATE	STEP	Section A	Initial Chief Eng	Action Description Chief Eng	n Description   Sign &   Section C   C			Approval QC Inspector
		holes for Rich are too		Scrop and Datos	m			
oslala	152	longe.	'/	SCRAP and Destoy and Replace Off	/"/		6-1110	

08/03/13 AJS 08.03.2

NOTE: Date & initial all entries

Monday, 2/25/2008 7:33:38 AM Date: Kim Johnston User: **Process Sheet** Drawing Name: STEP BRACKET Customer: CU-DAR001 Dart Helicopters Services Part Number: D37291 Job Number: 37580 Job Number: Description: Seq. #: , **Machine Or Operation:** INSPECT WORK TO CURRENT STEP QC5 AS NGINEERING HAND FINISHING1 HAND FINISHING RESOURCE #1 Comment: HAND FINISHING RESOURCE #1 Chemical Conversion Coat as per QSI 005 4.1 QC3 8.0 Cornelling Comment: INSPECT POWDER COAT/CHEMICAL CONVERSION PACKAGING RESOURCE #1 --9.0 Comment: PACKAGING RESOURCE #1 Identify wiith Dart part # using a fine point permanent marker and Stock . Location: GP 6 FINAL INSPECTION/W/O RELEASE 10.0 Comment: FINAL INSPECTION/W/O RELEASE Job Completion POSITIVE RECALL EFFECTIVE 08.02,25 AUTH 1 CELEASED AS DATE 0803,

## **Dart Aerospace Ltd**

Dail AC	OSpace	Ltu							
W/O:			WC	RK ORDER CHANG	ES				
DATE	STEP	PRO	OCEDURE CHAI	NGE	Ву	Date	Qty	Approval Chief Eng / Prod Mgr	Approval QC Inspector
			•						
Part No	):	PAR #:	Fault Cateo	gory:	_ NCR: Yes	No DQ	A:	Date: _	
							d:	Date: _	
NCR:		,	WORK ORDE	ER NON-CONFORMA	ANCE (NC	R)			
P. A =2 Pr	0755	Description of NC	<del></del>	Corrective Action Secti		Verifi	cation	Approval Chief Eng	Approval
DATE	STEP	Section A	Initial Chief Eng	Action Description Chief Eng	Sign Date	& Sect	ion C		QC Inspector
) -									
									•
								د د	

NOTE: Date & initial all entries

DART AEROSPACE LTD	Work Order: 37580
Description: Step Bracket	Part Number: D3729-1
Inspection Dwg: D3129 Rev: U/R	Page 1 of 1

## FIRST ARTICLE INSPECTION CHECKLIST

X	First Article	P	rototype

Drawing Dimension	Tolerance	Actual Dimension	Accept	Reject	Method of Inspection	
\$0.257	10.006-0.001	0.260	<b>₹</b> √		VerN	
1.40	+1-0.030	1.397	J		VWN	
4.38	+1-0.030	4.373	<b>V</b>		VWN	
0.75	4-0.030	0.748	1	- 1	VWN	
3.50	71-0.030	3.50	1		Yern	
0.750	+1-0.010	0.748	<b>V</b>		VEVN	
0.15	+1-0.030	0.75	<b>√</b>		VWN	
2.000	H-0.010	2.010	1		VWV	
1.000	+1-0.010	1.008	1		VEVN	
0.500	+1-0.010	0505	$\checkmark$		Vern	
0.675	4-0.010	0.665	$\checkmark$		vern	•
6.13	+1-0.030	6.13	J		VWN	
6.53	+1-0.030	6.53	(		VWN	
Rn.25 1.	+1-0.030	R 0.25	<b>V</b>		RG	
RO.59 -	H-0.030	RO.59	V		RG	
RO.29 +	H-0.030 1	10.29	V .	-	RG	
						-
						·
	The state of the s					
and the same					· [.	

		·	
Measured by: M. M.	Audited by:	Prototype Approval:	
Date: 08 03 12	Date:	Date:	
	· ———	 <del></del>	

Rev	Date	Change	 Revised by	Approved
Д		New Issue	KJ/JLM	

0 0 0

D3729-1 STEP BRACKET

AJS 08.02.25

NOTES: 1) MATERIAL: 6061-T6 (OR 6061-T62) ALUMINUM SHEET, 0.500 THICK PER AMS-QQ-A-250/11 OR AMS 4025 OR AMS 4027 (REF DART SPEC M6061T6S.500) OR: 6061-T6 (OR 6061-T651/T6510/T6511/T62) ALUMINUM BAR
PER AMS-QQ-A-225/8 (OR AMS 4117/4128/4115/4116) OR
PER AMS-QQ-A-200/8 (OR AMS 4160)
(REF DART SPEC M6061T6B)

2) FINISH: CHEMICAL CONVERSION COAT PER DART QSI 005 4.1
3) TOLERANCES: PER DART QSI 018 UNLESS OTHERWISE NOTED 4) UNITS: INCHES UNLESS OTHERWISE NOTED


5) BREAK SHARP EDGES: 0.005 TO 0.010 MAX 6) IDENTIFICATION: N/A

Α **NEW ISSUE** 08.02.04 REV. DESCRIPTION DATE **DESIGN** AJS DART AEROSPACE LTD DRAWN HAWKESBURY, ONTARIO, CANADA DRAWING NO. CHECKED REV. B D3729 MFG. APPR. SHEET 1 OF 2 TITLE APPROVED STEP BRACKET DE APPR. COPYRIGHT © 2008 BY DART AEROSPACE LTD DATE 08.02.22 THIS DOCUMENT IS PRIVATE AND CONFIDENTIAL AND IS SUPPLIED ON THE EXPRESS CONDITION THAT IT IS NOT TO BE USED FOR ANY PURPOSE OR COPIED OR COMMUNICATED TO ANY OTHER PERSON WITHOUT

SHEET 2 ZONE 8C, 2.520 DIM WAS 2.51 & TOLERANCE HAS BEEN UPDATED. ZONE 7B & 7C, Ø0.159 HOLES ADDED.

08.02.22

7) WEIGHT: 0.99 lbs

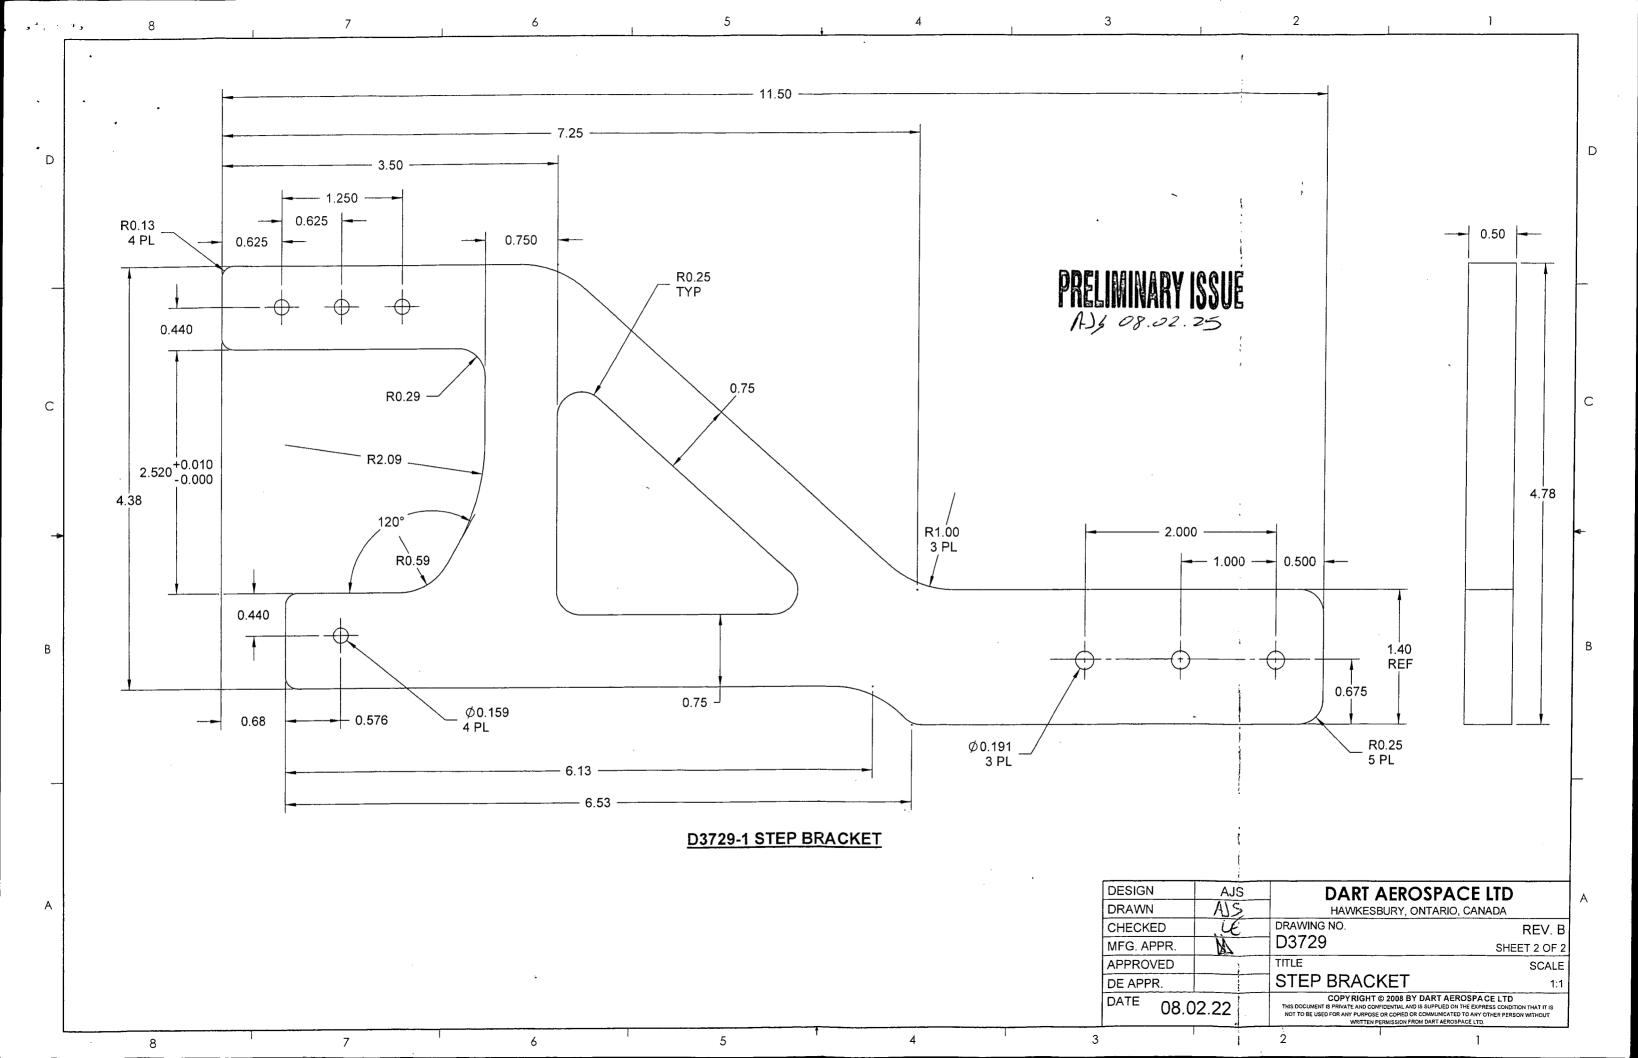

DART AEROSPACE LTD	Work Order: 37580
Description: STED BRACKET	Part Number: D3729-1
Inspection Dwg:D3729-1 Rev: U/R	Page 1 of 1

## FIRST ARTICLE INSPECTION CHECKLIST

X First Article Prototype

Drawing Dimension	Tolerance	Actual Dimension	Accept	Reject	Method of Inspection	Comments
Ø ,191	1,005-001	:194	*			
Ø .159	100 - 200. +	(162	¥			
,440	4010	,440	*			
, 675	4610	.626	×			
.635	4/ olo	.637	#			
1. 350	4- 1010	1.250	×	j		
<u>,</u> 7\$0	400	.756	*			
3,50	4030	3,50	¥		· · · · · · · · · · · · · · · · · · ·	
4.38	4_ 030	4.39	*			
<i>∂.</i> €20	-/010	2,515	¥			
,576	4-,00	.571	*			•
7.25	4/030	7.75	¥			
11.50	t/- ,030	11.50	A			
.675	4/010	1675	¥			
·	4030	1.409	¥			
	4/010	490	*			
1.000	4.010	1,000	*			
600. C	7010		A			
,50	7- ,030	.495	*			•
				·		
-						

			<i>'</i>	•	
Measured by: 18	Audited by:			Prototype Approval:	
Date: 8-3-35	Date:	1	1427	Date:	

Rev	Date	Change	 Revised by	Approved
A		New Issue	KJ/JLM	

0 0 0 0

**D3729-1 STEP BRACKET** 

PRELIMINARY ISSUE

A) 5003.10

С

NOTES: 1) MATERIAL: 6061-T6 (OR 6061-T62) ALUMINUM SHEET, 0.500 THICK PER AMS-QQ-A-250/11 OR AMS 4025 OR AMS 4027 (REF DART SPEC M6061T6S.500) OR: 6061-T6 (OR 6061-T651/T6510/T6511/T62) ALUMINUM BAR PER AMS-QQ-A-225/8 (OR AMS 4117/4128/4115/4116) OR PER AMS-QQ-A-200/8 (OR AMS 4160) (REF DART SPEC M6061T6B) 2) FINISH: CHÈMICAL CONVERSION COAT PER DART QSI 005 4.1 3) TOLERANCES: PER DART QSI 018 UNLESS OTHERWISE NOTED

4) UNITS: INCHES UNLESS OTHERWISE NOTED 5) BREAK SHARP EDGES: 0.005 TO 0.010 MAX 6) IDENTIFICATION: N/A 7) WEIGHT: 0.99 lbs


8

• D

SHEET 2 ZONE 4B  $\phi$ 0.257 HOLE WAS  $\phi$ 0:191, 8C 2.520 DIM WAS 2.51 & TOLERANCE HAS BEEN UPDATED. ZONE 7B & 7C  $\phi$ 0.159 HOLES ADDED. AJS 08.02.22 **NEW ISSUE** AJS 08.02.04 REV. DESCRIPTION DATE **DESIGN DART AEROSPACE LTD** AJS DRAWN HAWKESBURY, ONTARIO, CANADA DRAWING NO. CHECKED REV. B D3729 MFG. APPR. SHEET 1 OF 2 APPROVED TITLE **SCALE** STEP BRACKET DE APPR. COPYRIGHT © 2008 BY DART AEROSPACE LTD

08.02.22 THIS DOCUMENT IS PRIVATE AND CONFIDENTIAL AND IS SUPPLIED ON THE EXPRESS CONDITION THAT IT IS NOT TO BE USED FOR ANY PURPOSE OR COPIED OR COMMUNICATED TO ANY OTHER PERSON WITHOUT WRITTEN PERMISSION FROM DART AEROSPACE LTD.

DATE

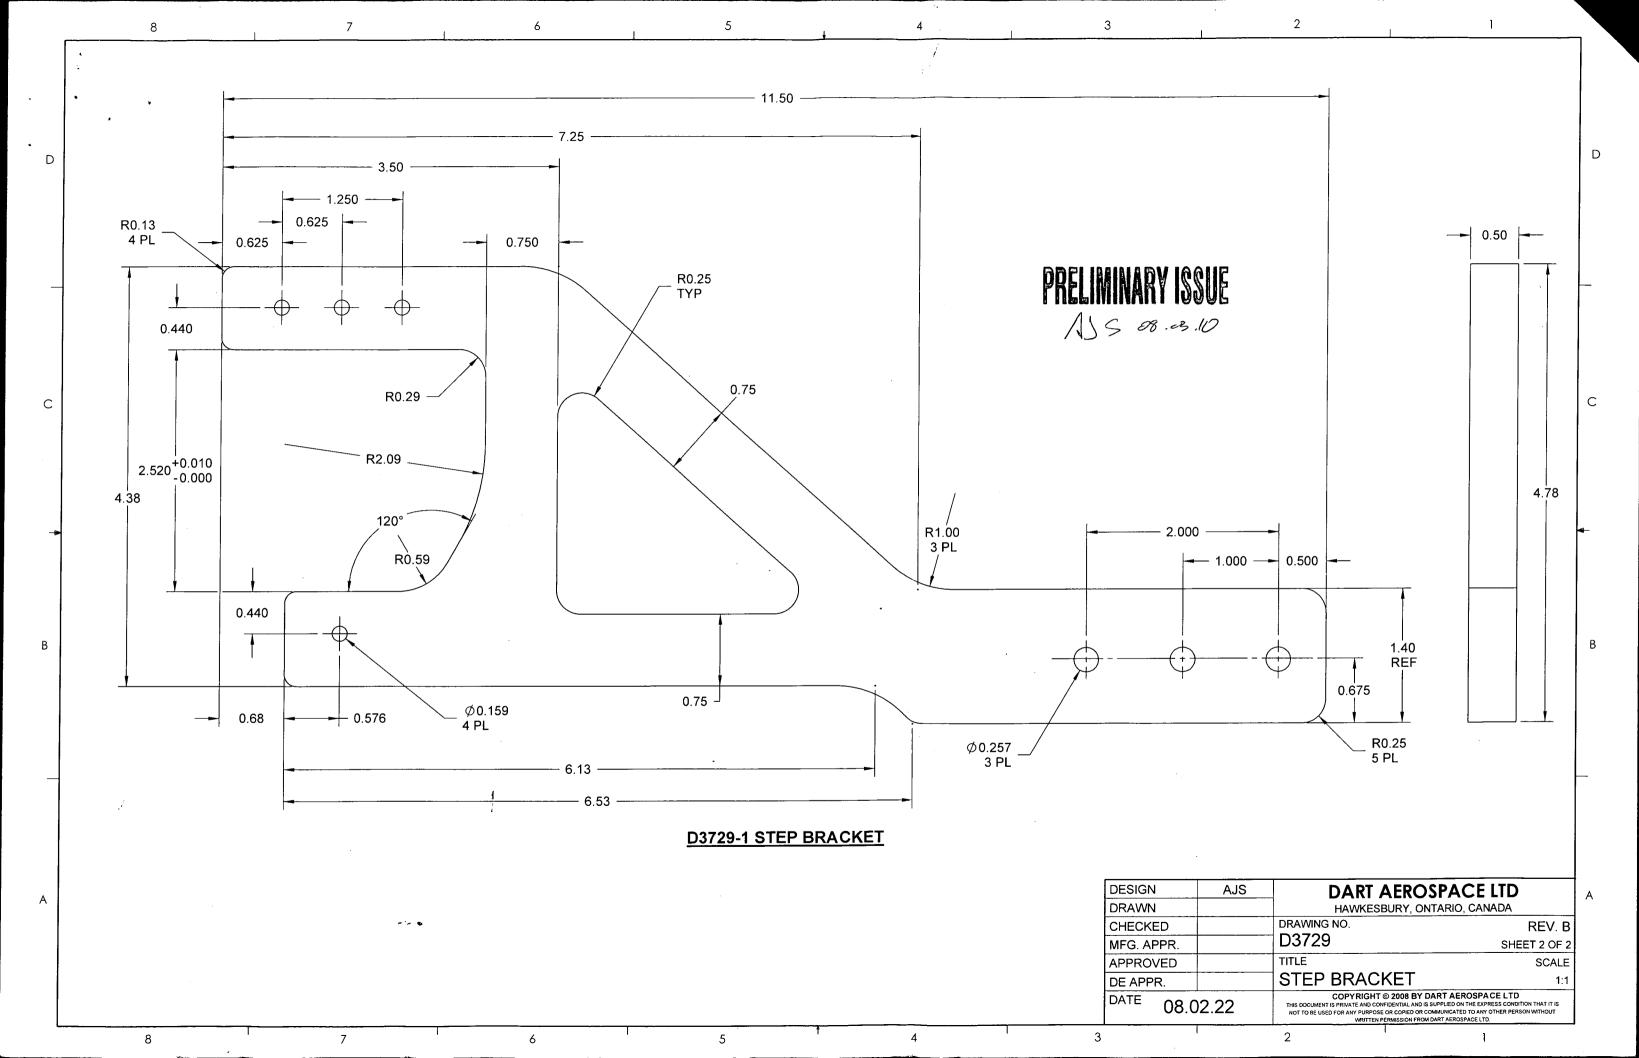

0 0 D3729-1 STEP BRACKET NOTES: 1) MATERIAL: 6061-T6 (OR 6061-T62) ALUMINUM SHEET, 0.500 THICK PER AMS-QQ-A-250/11 OR AMS 4025 OR AMS 4027 SHEET 2 ZONE 4B Ø0.257 HOLE WAS Ø0.191, 8C 2.520 DIM WAS 2.51 & TOLERANCE HAS BEEN UPDATED. ZONE 7B & 7C Ø0.159 HOLES ADDED. 08.02.22 AJS (REF DART SPEC M6061T6S.500)
OR: 6061-T6 (OR 6061-T651/T6510/T6511/T62) ALUMINUM BAR PER AMS-QQ-A-225/8 (OR AMS 4117/4128/4115/4116) OR PER AMS-QQ-A-200/8 (OR AMS 4160) NEW ISSUE 08.02.04 REV. DESCRIPTION BY DATE DESIGN DART AEROSPACE LTD AJS (REF DART SPEC M6061T6B)

2) FINISH: CHEMICAL CONVERSION COAT PER DART QSI 005 4.1

3) TOLERANCES: PER DART QSI 018 UNLESS OTHERWISE NOTED

4) UNITS: INCHES UNLESS OTHERWISE NOTED DRAWN HAWKESBURY, ONTARIO, CANADA DRAWING NO. CHECKED REV. B D3729 MFG. APPR. SHEET 1 OF 2 5) BREAK SHARP EDGES: 0.005 TO 0.010 MAX APPROVED TITLE 6) IDENTIFICATION: N/A STEP BRACKET DE APPR. NTS 7) WEIGHT: 0.99 lbs COPYRIGHT © 2008 BY DART AEROSPACE LTD

THIS DOCUMENT IS PRIVATE AND CONFIDENTIAL AND IS SUPPLIED ON THE EXPRESS CONDITION THAT IT IS NOT TO BE USED FOR ANY PURPOSE OR COPIED OR COMMUNICATED TO ANY OTHER PERSON WITHOUT WAITTEN PERMISSION FROM DART AEROSPACE LTD. 08.02.22 3 8

